

WARNING PROPOSED SERVICES
 THE LOCATION AND EXTENT OF PROPOSED SERVICES IS INDICATIVE ONLY AND ARE NOT TO BE USED FOR CONSTRUCTION. REFER TO AUTHORISED DOCUMENTATION BY RELEVANT AUTHORITY FOR CONSTRUCTION DETAILS

WARNING BEWARE OF UNDERGROUND SERVICES
 THE LOCATIONS OF UNDERGROUND SERVICES ARE APPROXIMATE ONLY AND THEIR EXACT POSITION SHOULD BE PROVEN ON SITE. NO GUARANTEE IS GIVEN THAT ALL EXISTING SERVICES ARE SHOWN.




SCHEDULE 5. SERVICE OFFSET TABLE

STREET NAME	GAS	NDW	WATER	TELECOMMS	ELECTRICITY
SURIN ROAD	2.10	N 2.60	N 3.10	N 1.85	S 2.65
KOMODO DRIVE	2.10	E 2.60	E 3.10	E 1.85	W 2.65
TATRA STREET	2.10	N 2.60	N 3.10	N 1.85	S 2.65
BAGARAM DRIVE	1.70	S 2.15	S 2.65	S 3.10	S 2.65

NOTE: OFFSETS SHOWN ARE IN METRES (m)

REV	DESCRIPTION	BY	APP	DATE
01	CONSTRUCTION ISSUE	HE	LG	10.03.17
02	CONSTRUCTION ISSUE - HOGANS ROAD UPDATE	HE	LG	15.11.17
03	CONSTRUCTION ISSUE - LOT 202 DRIVEWAY REGRADING	DC	LG	24.11.17
04	CONSTRUCTION ISSUE - LOT 238 GAW RELOCATED	HE	LG	03.05.18
05	CONSTRUCTION ISSUE - POS AMEND	RT	LG	14.08.18
000	AS BUILT	RT	RP	27.02.19

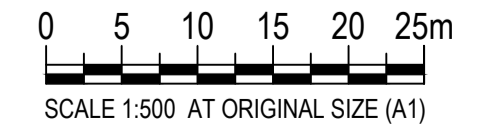

CLIENT
 TARNIET PROJECTS PTY LTD
 P.O BOX 8023
 CAMBERWELL NORTH, VIC. 3124

TITLE
 LAYOUT PLAN

PROJECT
 GRACE - STAGE 2
 605 HOGANS ROAD, TARNEIT
 WYNDHAM CITY COUNCIL

STATUS
 AS BUILT

DESIGNED	DRAWN	APPROVED	SCALE @ A1	SHEET
LG	HE	AC	SHOWN	3 of 15
PROJECT No	DRAWING No	REV		
114652-02	C100	B00		

COUNCIL REFERENCE NUMBER
 SDW2193/17
 SHEET NUMBER
 3 OF 15

DWG FILE: X:\114652_025_Hogans Road\Tarniet\62626_3.MPT.LD\STAGE 02\114652-02-C100.dwg - MPT PLOT TIME: 27 Feb 2019, 2:39pm